



KEY MAP

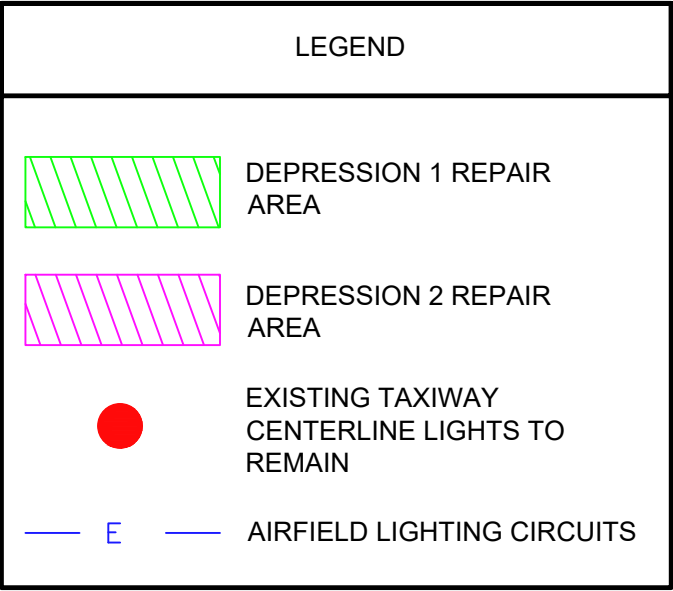


NOTES:


1. GROUT INJECTIONS TO BE FULLY COMPLETED PRIOR TO FULL DEPTH PAVEMENT DEMOLITION. FULL DEPTH RECONSTRUCTION MAY BEGIN 48 HOURS AFTER FULL COMPLETION OF GROUT INJECTIONS.
2. CONTRACTOR TO PROTECT TAXIWAY CENTERLINE LIGHTS. PAVEMENT REPAIR LIMITS SHALL BE ADJUSTED TO REMAIN 5 FEET FROM TAXIWAY CENTERLINE LIGHTING. CONES AND/OR BARRICADES SHALL BE PLACED AROUND LIGHTS IN VICINITY OF PAVEMENT REPAIRS TO PROTECT EXISTING LIGHTING. ANY DAMAGE TO THE TAXIWAY LIGHTING SHALL BE REPAIRED AT THE CONTRACTORS EXPENSE.
3. CONTRACTOR SHALL TAKE CARE TO NOT IMPACT EXISTING MARKINGS OUTSIDE OF THE PAVING AREA. ANY MARKINGS DAMAGED OUTSIDE OF THE PAVING AREA SHALL BE CLEANED AND RESTRIPE AT CONTRACTORS EXPENSE. ALL LOCATIONS TO BE RESTRIPE SHALL BE THOROUGHLY CLEANED AND DRY PER SPECIFICATION P-620 PRIOR TO INSTALLATION OF ANY STRIPING.
4. PROPOSED PAVING AREAS SHALL BE PAVED IN A DIRECTION PARALLEL TO THE TAXIWAY CENTERLINE AND SHALL MATCH EXISTING GRADES. UNDERLYING LIFT JOINTS SHALL BE STAGGERED A MINIMUM OF 12".
5. PROPOSED MARKINGS SHALL EXTEND 40' BEYOND PAVING LIMITS.
6. CONTRACTOR SHALL ONLY PLACE TEMPORARY STRIPING FOR YELLOW MARKINGS ONLY ONCE ASPHALT HAS HAD 24 HOURS TO CURE AND COOL. FINAL STRIPING SHALL NOT OCCUR UNTIL THE NEW ASPHALT HAS HAD A MINIMUM OF 30 DAYS TO CURE AT WHICH TIME BLACK PAINT CAN BE APPLIED.

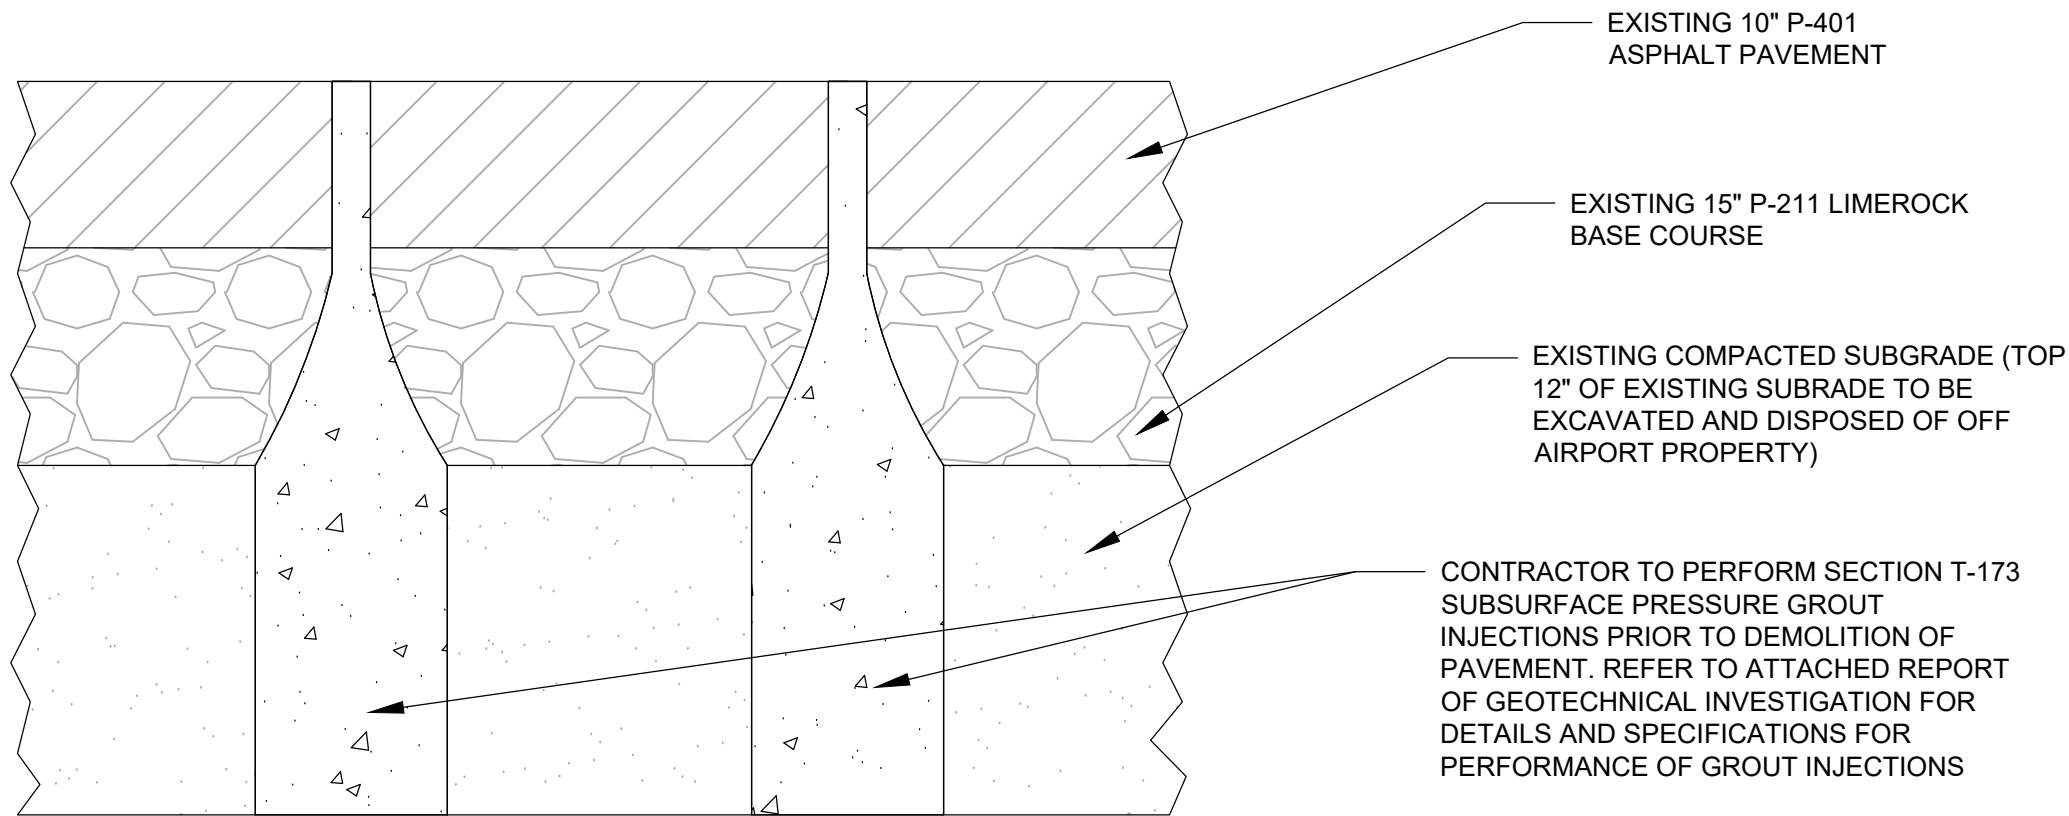

1
C100
EXISTING TYPICAL SECTION WITH GROUT INJECTIONS
SCALE: NTS
NOTE: CONTRACTOR SHALL TAKE SPECIAL CARE AS TO NOT IMPACT AND/OR DAMAGE THE EXISTING TAXIWAY CENTERLINE LIGHTS. REFER TO NOTE 2 ON THIS SHEET.

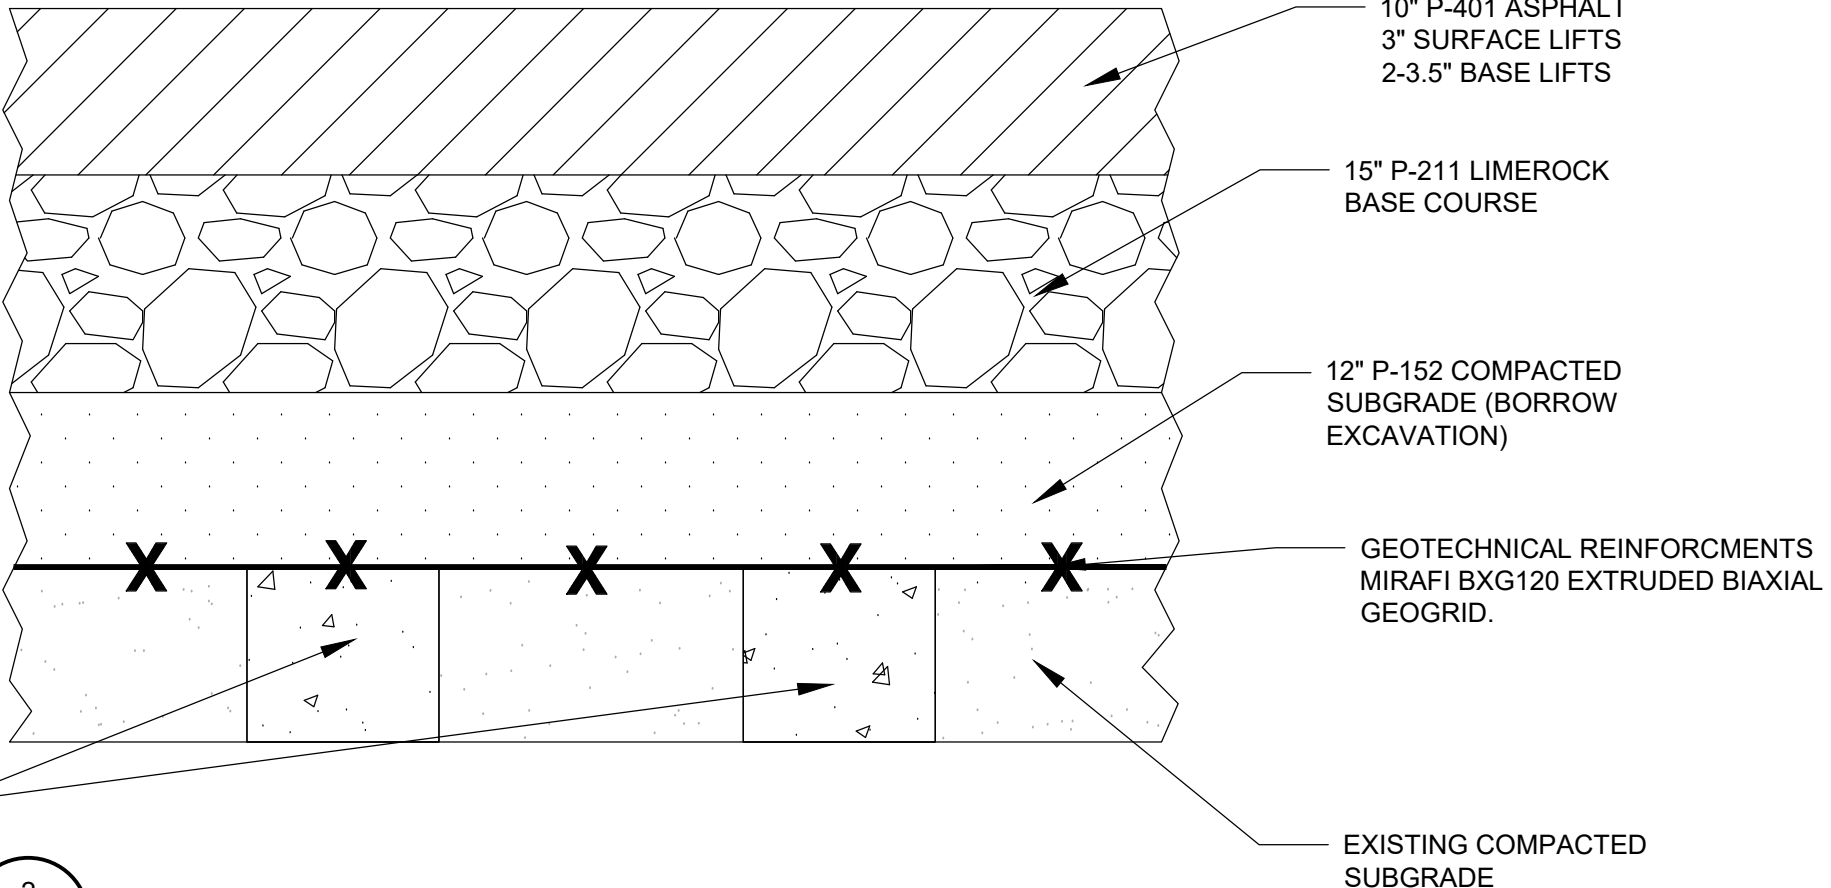

2
C100
PROPOSED TYPICAL SECTION
SCALE: NTS
NOTE: CONTRACTOR SHALL TAKE SPECIAL CARE AS TO NOT IMPACT AND/OR DAMAGE THE EXISTING TAXIWAY CENTERLINE LIGHTS. REFER TO NOTE 2 ON THIS SHEET.

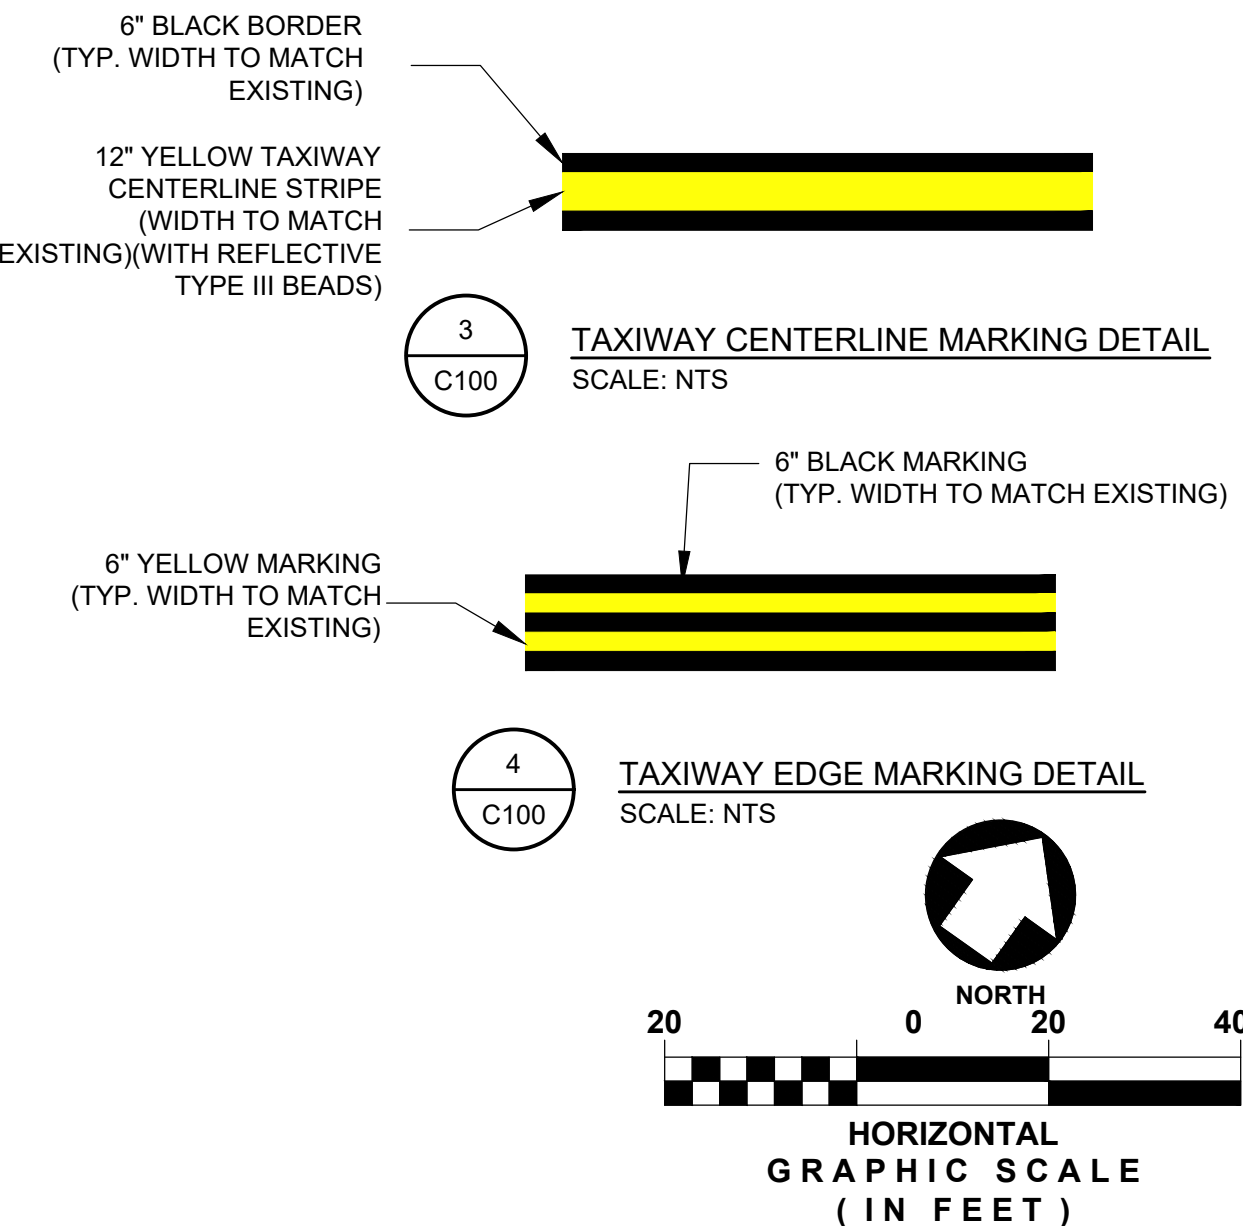

RS&H, Inc.
3125 W. Commercial Blvd., Suite 130
Fort Lauderdale, FL 33309
954-474-3005 FAX 954-474-3006



TAXIWAY "F" EAST
END DEPRESSION
REPAIRS

MICHAEL S. STRICKLER, PE
FL REGISTRATION NO. 72400

REVISIONS

DATE ISSUED: DECEMBER 2023
REVIEWED BY: MSS
DRAWN BY: NKJ
DESIGNED BY: MSS

RS&H PROJECT NUMBER
1004-1890-031

© 2021 RS&H, INC.

SHEET TITLE

PAVEMENT REPAIR
PLANS AND DETAILS

SHEET NUMBER

C100

RECORD DRAWINGS